


WEST ELEVATION

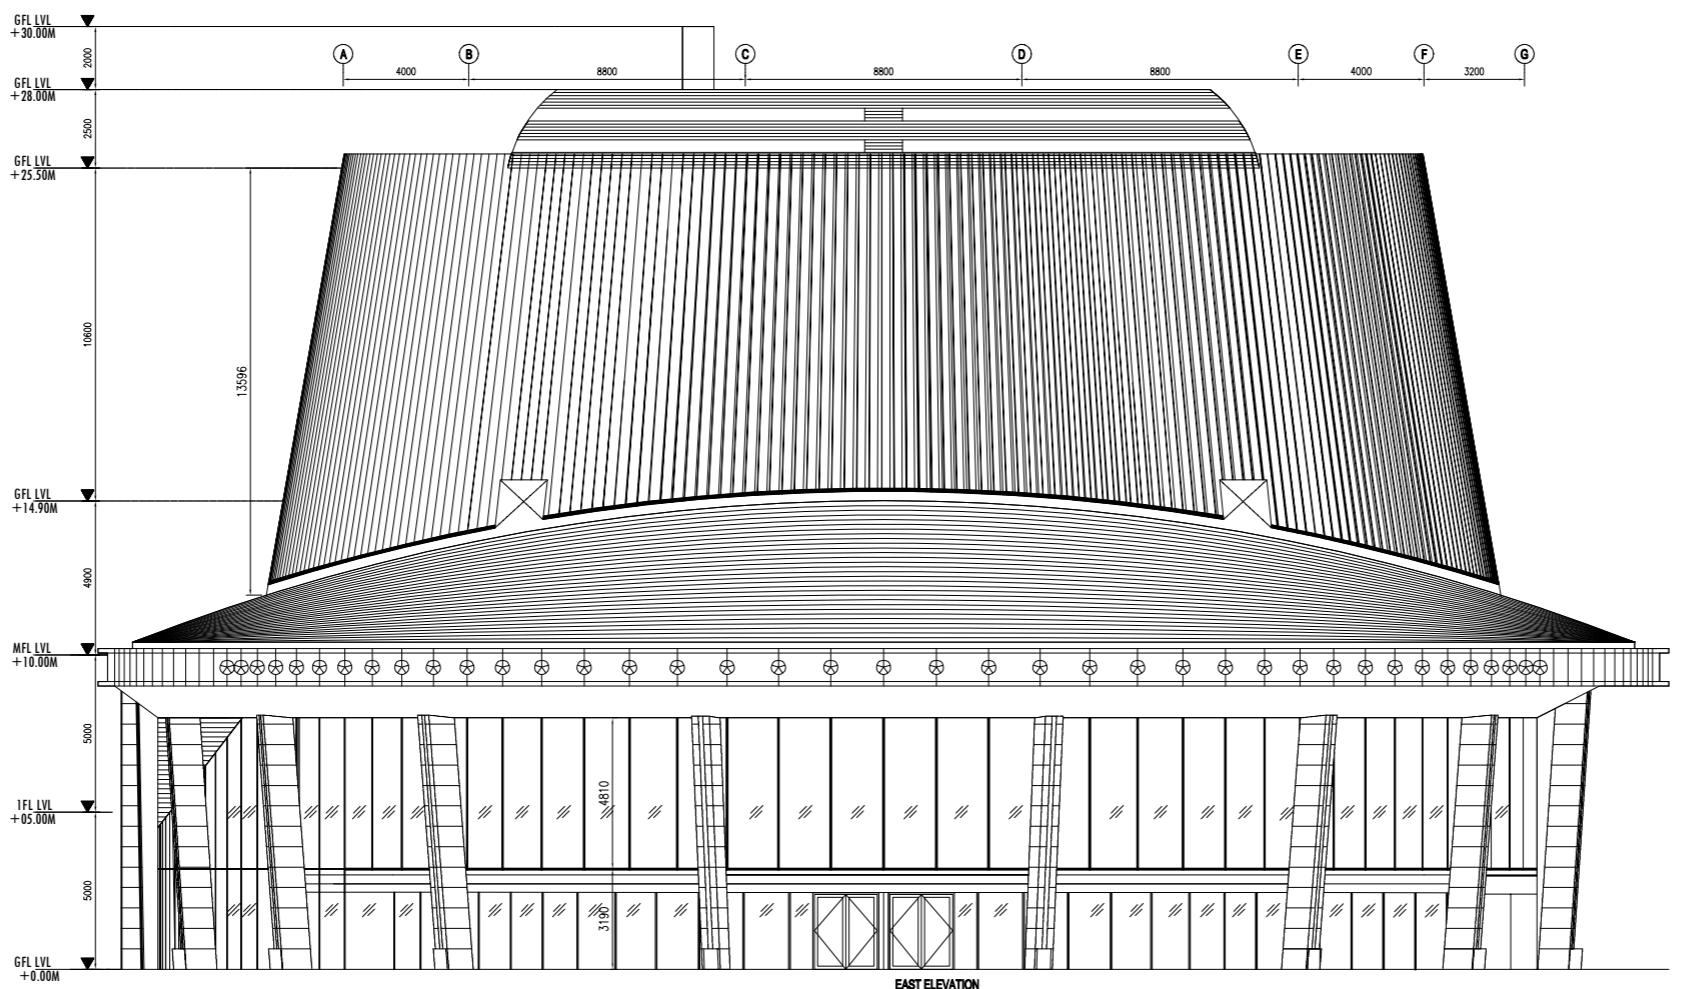

EAST ELEVATION

PROJECT TITLE  
**THE PROJECT FOR CONSTRUCTION OF THE INTERNATIONAL COOPERATION AND CONVENTION CENTER IN VARANASI**

GENERAL NOTE

NO	DATE	DESCRIPTIONS

CLIENT  
**THE MINISTRY OF HOUSING & URBAN AFFAIRS**

SCALE  
**1:100 (A1)**

DWG NAME  
**EAST & WEST ELEVATION**

DESIGNED BY : ORIENTAL CONSULTANTS GLOBAL CO.LTD. & NIKKEN SEKKEI  
 CONTRACTOR : FUJITA CORPORATION

DWG TITLE  
**AS BUILT**

DWG NO  
**A0-11**