

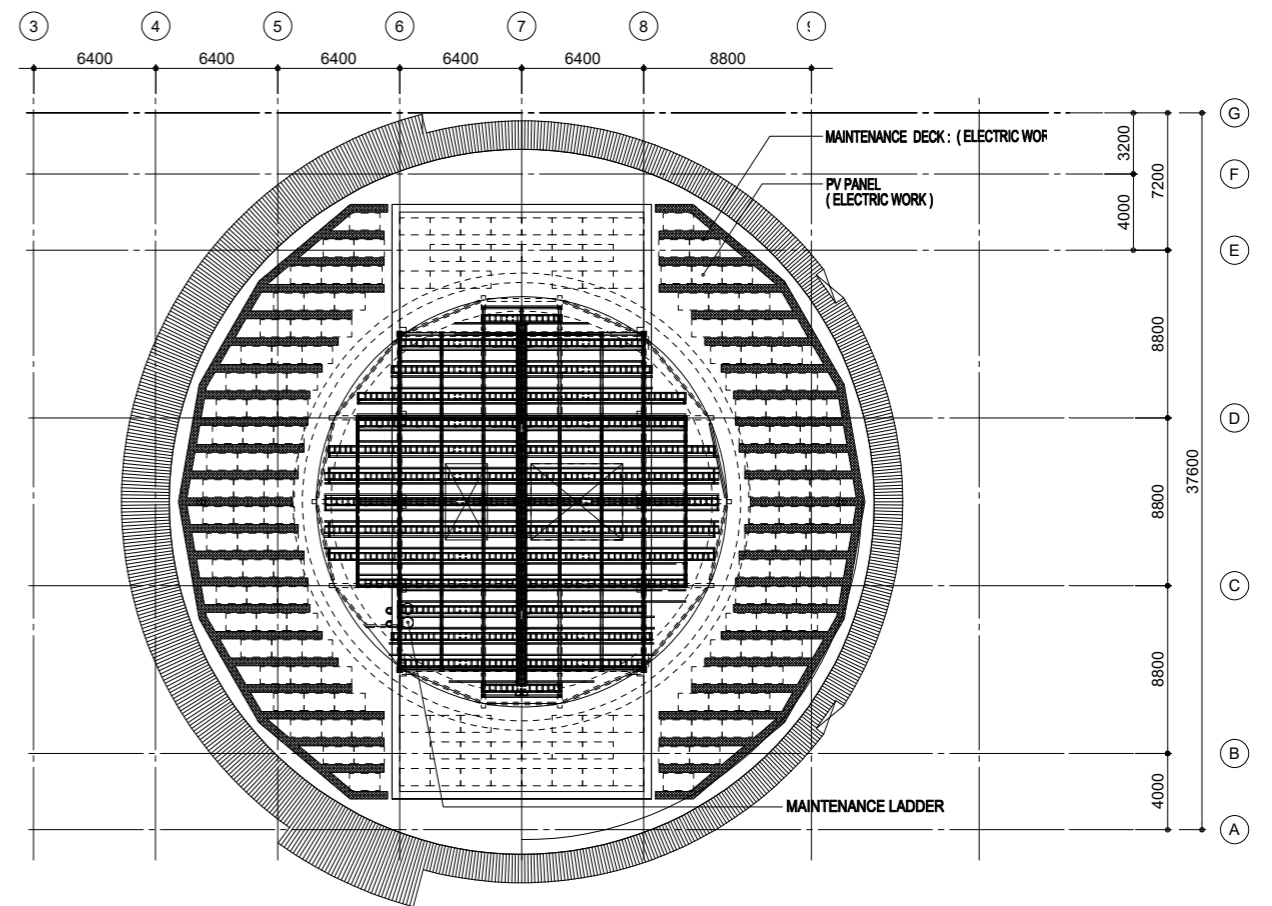


GFL + 14500

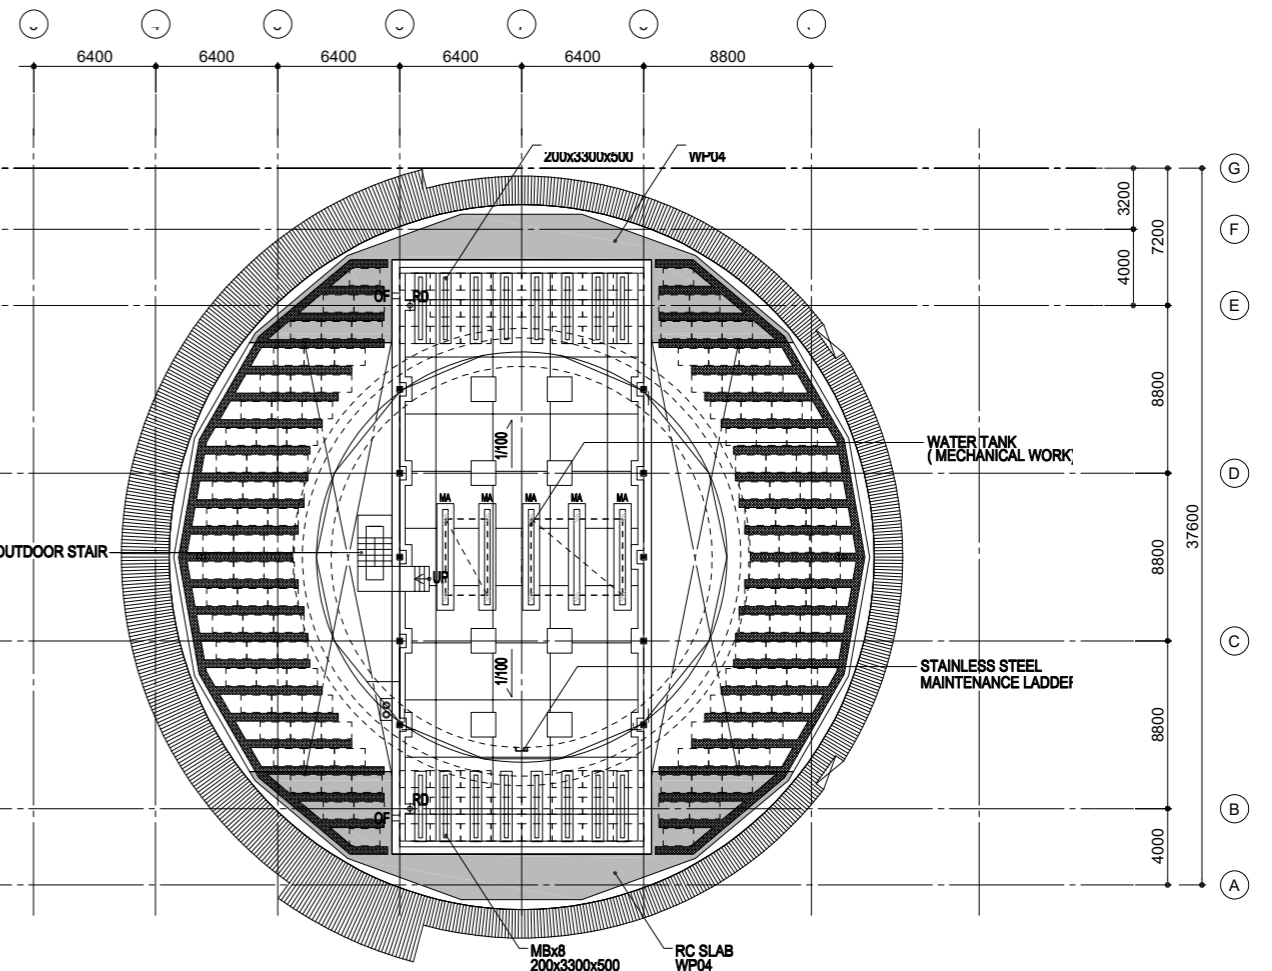

GFL + 22500

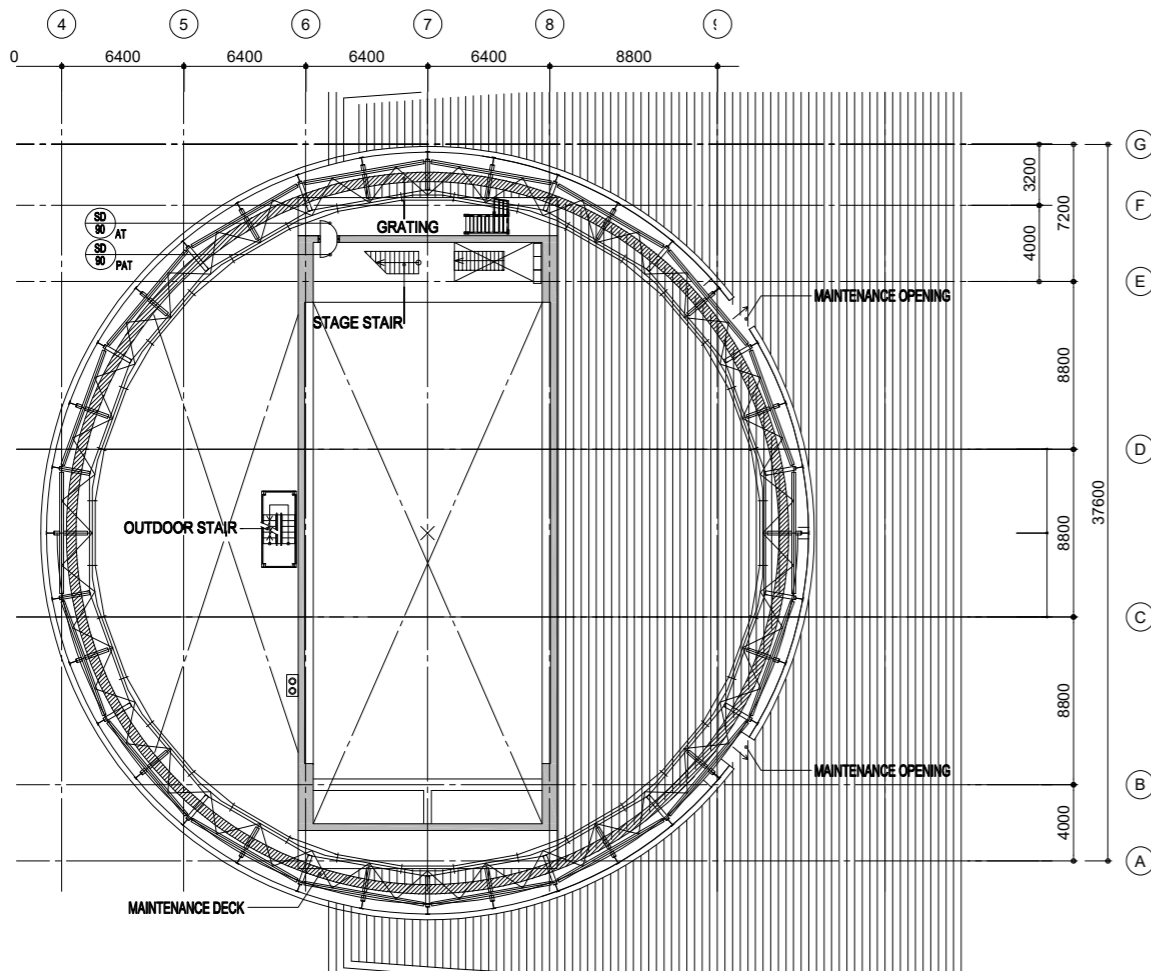

PROJECT TITLE
 THE PROJECT FOR CONSTRUCTION OF THE INTERNATIONAL COOPERATION AND CONVENTION CENTER IN VARANASI

GENERAL NOTE

NO	DATE	DESCRIPTIONS

CLIENT
 THE MINISTRY OF HOUSING & URBAN AFFAIRS

SCALE
 1:50 (A1)
 DATE
 MAR. 2021

DWG NAME
FLYTOWER PLAN
 DESIGNED BY: ORIENTAL CONSULTANTS GLOBAL CO.LTD. & NIKKEN SEKKEI
 CONTRACTOR: FUJITA CORPORATION

DWG TITLE
 AS BUILT
 DWG NO
 A0-8